

STATE OF UTAH
DEPARTMENT OF NATURAL RESOURCES
DIVISION OF OIL, GAS AND MINING
1594 West North Temple - Suite 1210
Box 145801
Salt Lake City, Utah 84114-5801
Telephone: (801) 538-5291
Fax: (801) 359-3940

LARGE MINING OPERATIONS 2008 PROGRESS REPORT
January 1, 2008 to December 31, 2008

The information required in this form are based on provisions of the Mined Land Reclamation Act, Title 40-8, and the rules as under the Utah Minerals Regulatory Program.

1. Mine Permit Number: M/023/023
2. Mine Name: Lavan - Henry
3. Name of Operator/Permittee: Sunroc Corporation

Note: If Operator's address, company representative or phone number have changed, please provide a replacement page for the Notice of Intention.

4. Mine Location: 3 miles South of Lavan on Hwy 28

5. Report the gross amount of ore mined and waste moved, and the disposition of the materials (onsite stockpiles, sold, waste pile, regraded, etc.):

Gross Ore Mined 0 Tons, or yd³
Waste Material Moved 0 Tons, or yd³
New Disturbance 0 Acres during 2008
Area Reclaimed 0 Acres during 2008
Total Disturbed Area 12.32 Acres*

*Total mine disturbance from the beginning of mining operations through the end of 2008.

Was the ore shipped off site? If not, where is the ore located? N/A

Where is the waste located? West end of processing pad

6. Briefly describe the reclamation work performed during the past year. A map showing reclaimed areas and dates is suggested. (Submit form MR-SITE for an application for full or partial bond/site release).

none

7. Include an updated map depicting surface disturbance and reclamation performed during the year, prepared in accordance with Rule R647-4-105.

I hereby certify, under penalties of law, the information provided in this report is true and correct to the best of my knowledge and belief.



Name (Typed or Print): Tony L. Christofferson
Title of Operator: Property / Environmental Manager
Signature of Operator: Tony L. Christofferson
Date: 1-22-09

RECEIVED

JAN 26 2009

0001

DIV. OF OIL, GAS & MINING

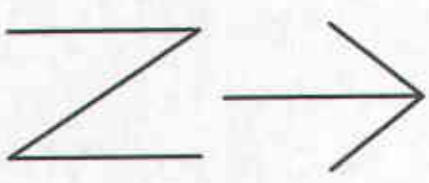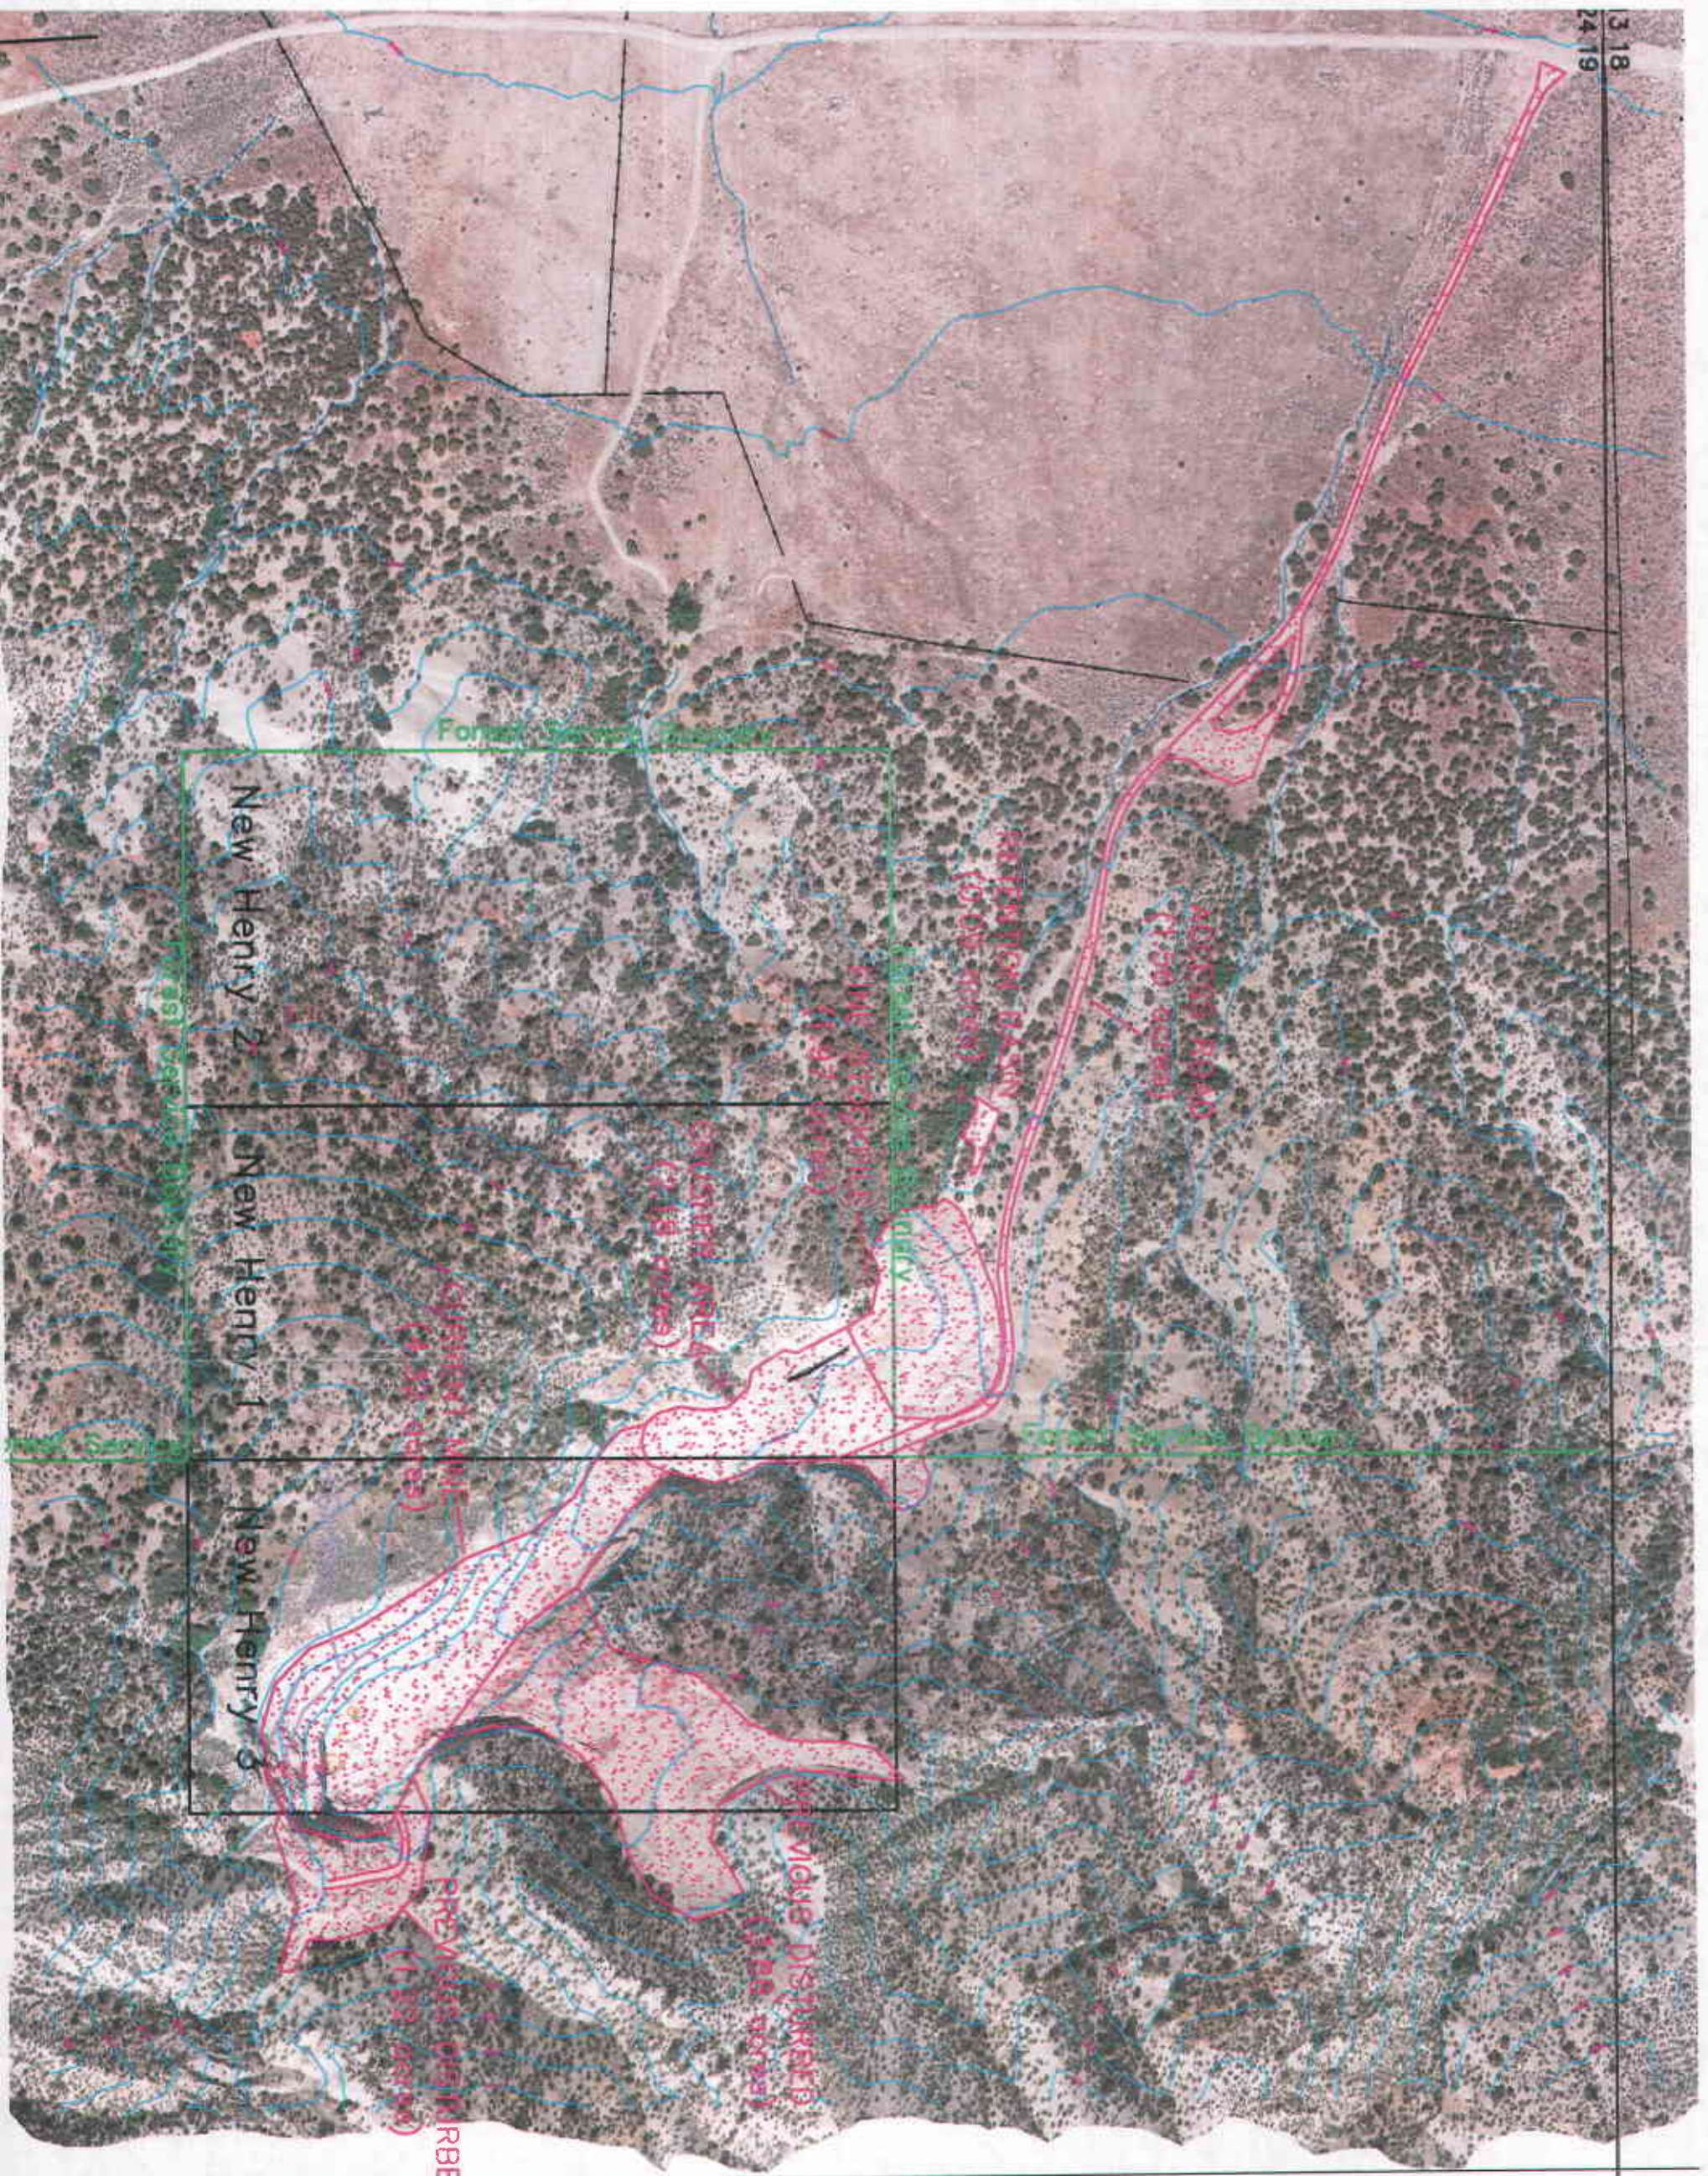

Scale: 1" = 300'

DISTURBED AREA MAP	
of the	
LEVAN HENRY MINE	
SUNROC CORPORATION	
St. George, Utah	
(acres disturbed) contour interval 50'	
Date: 3/20/06	Drawing # III-A

W 1/2, SW 1/4, NE 1/4,
Sec. 19, T 15 S, R 1 E,
SLB & M.

E 1/2, SE 1/4, NW 1/4,
Sec. 19, T 15 S, R 1 E,
SLB & M.

DISTURBED AREA =
13.66 acres

RECEIVED

JAN 26 2009

DIV. OF OIL, GAS & MINING